A1

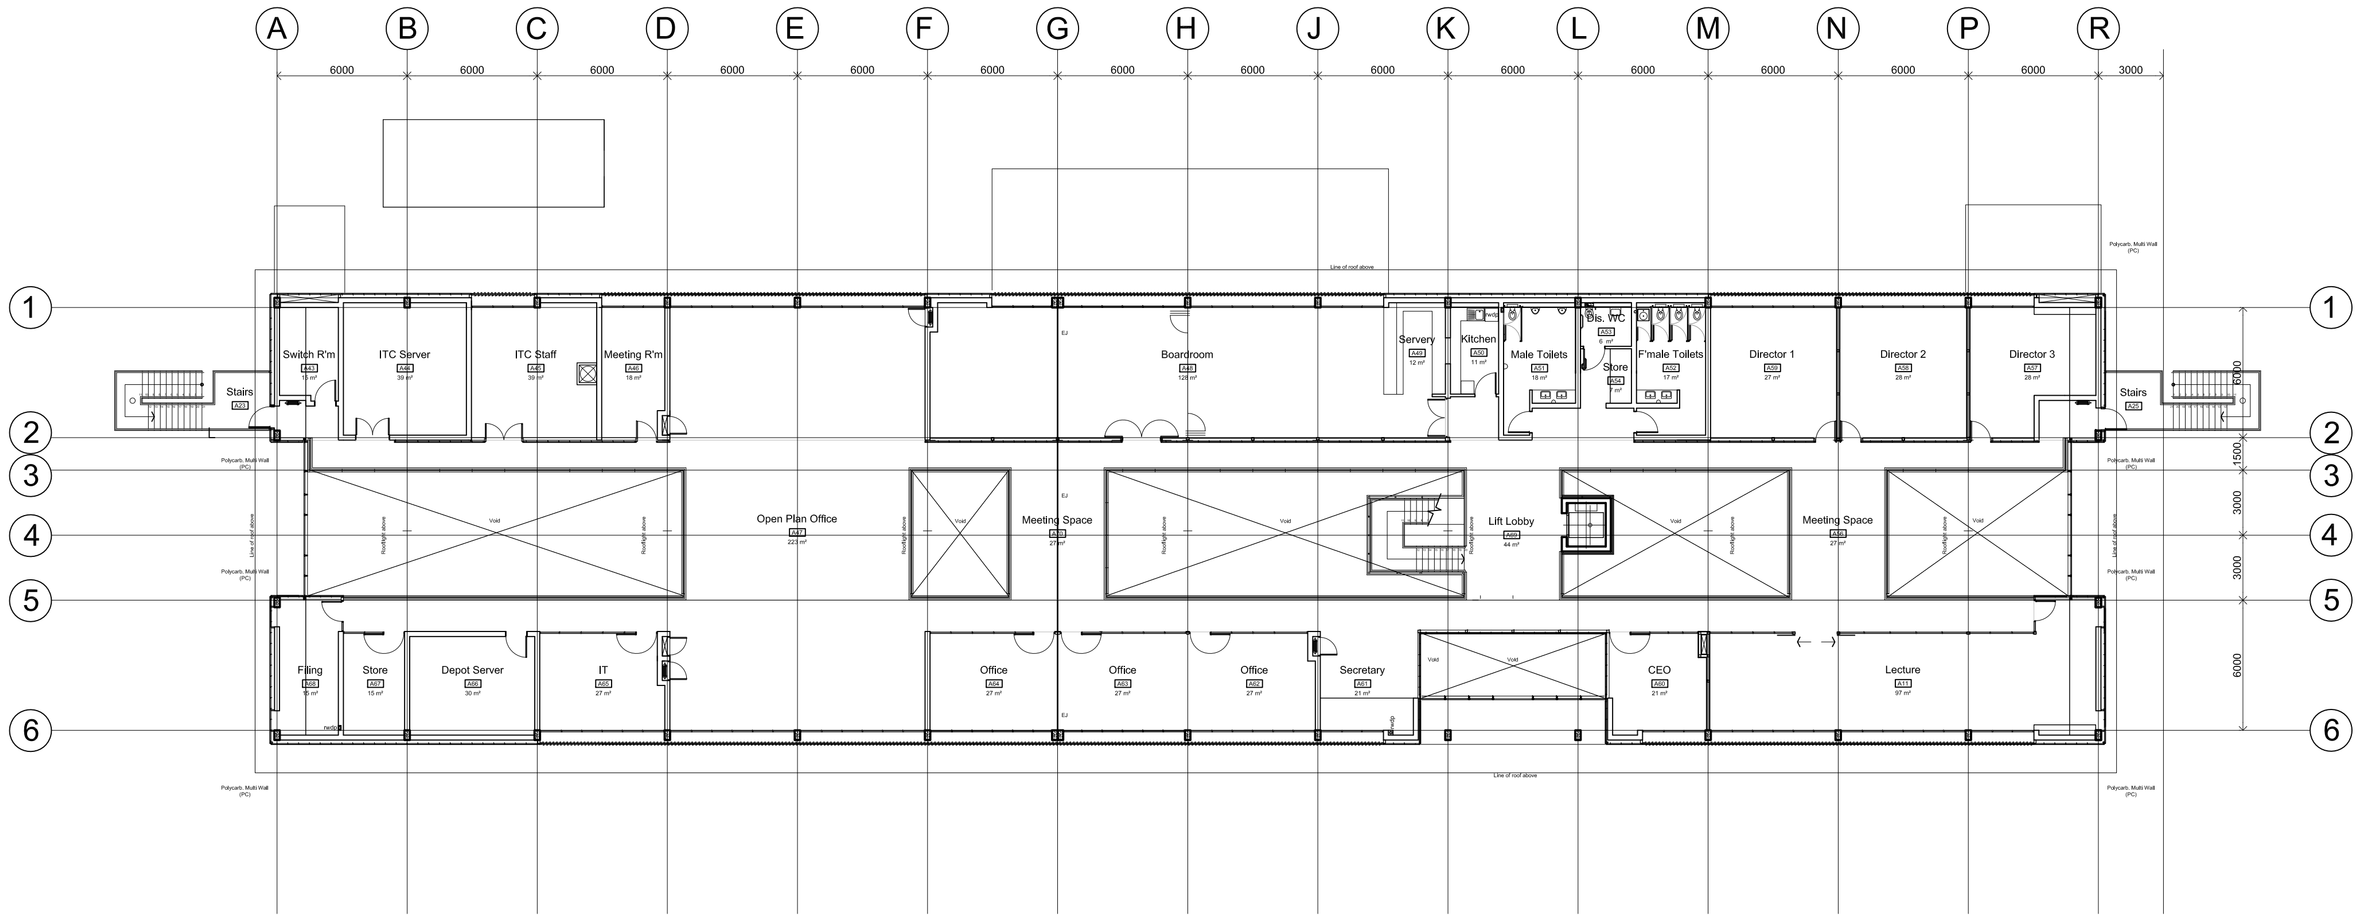

First Floor Plan

Scale 1:200 @ A1

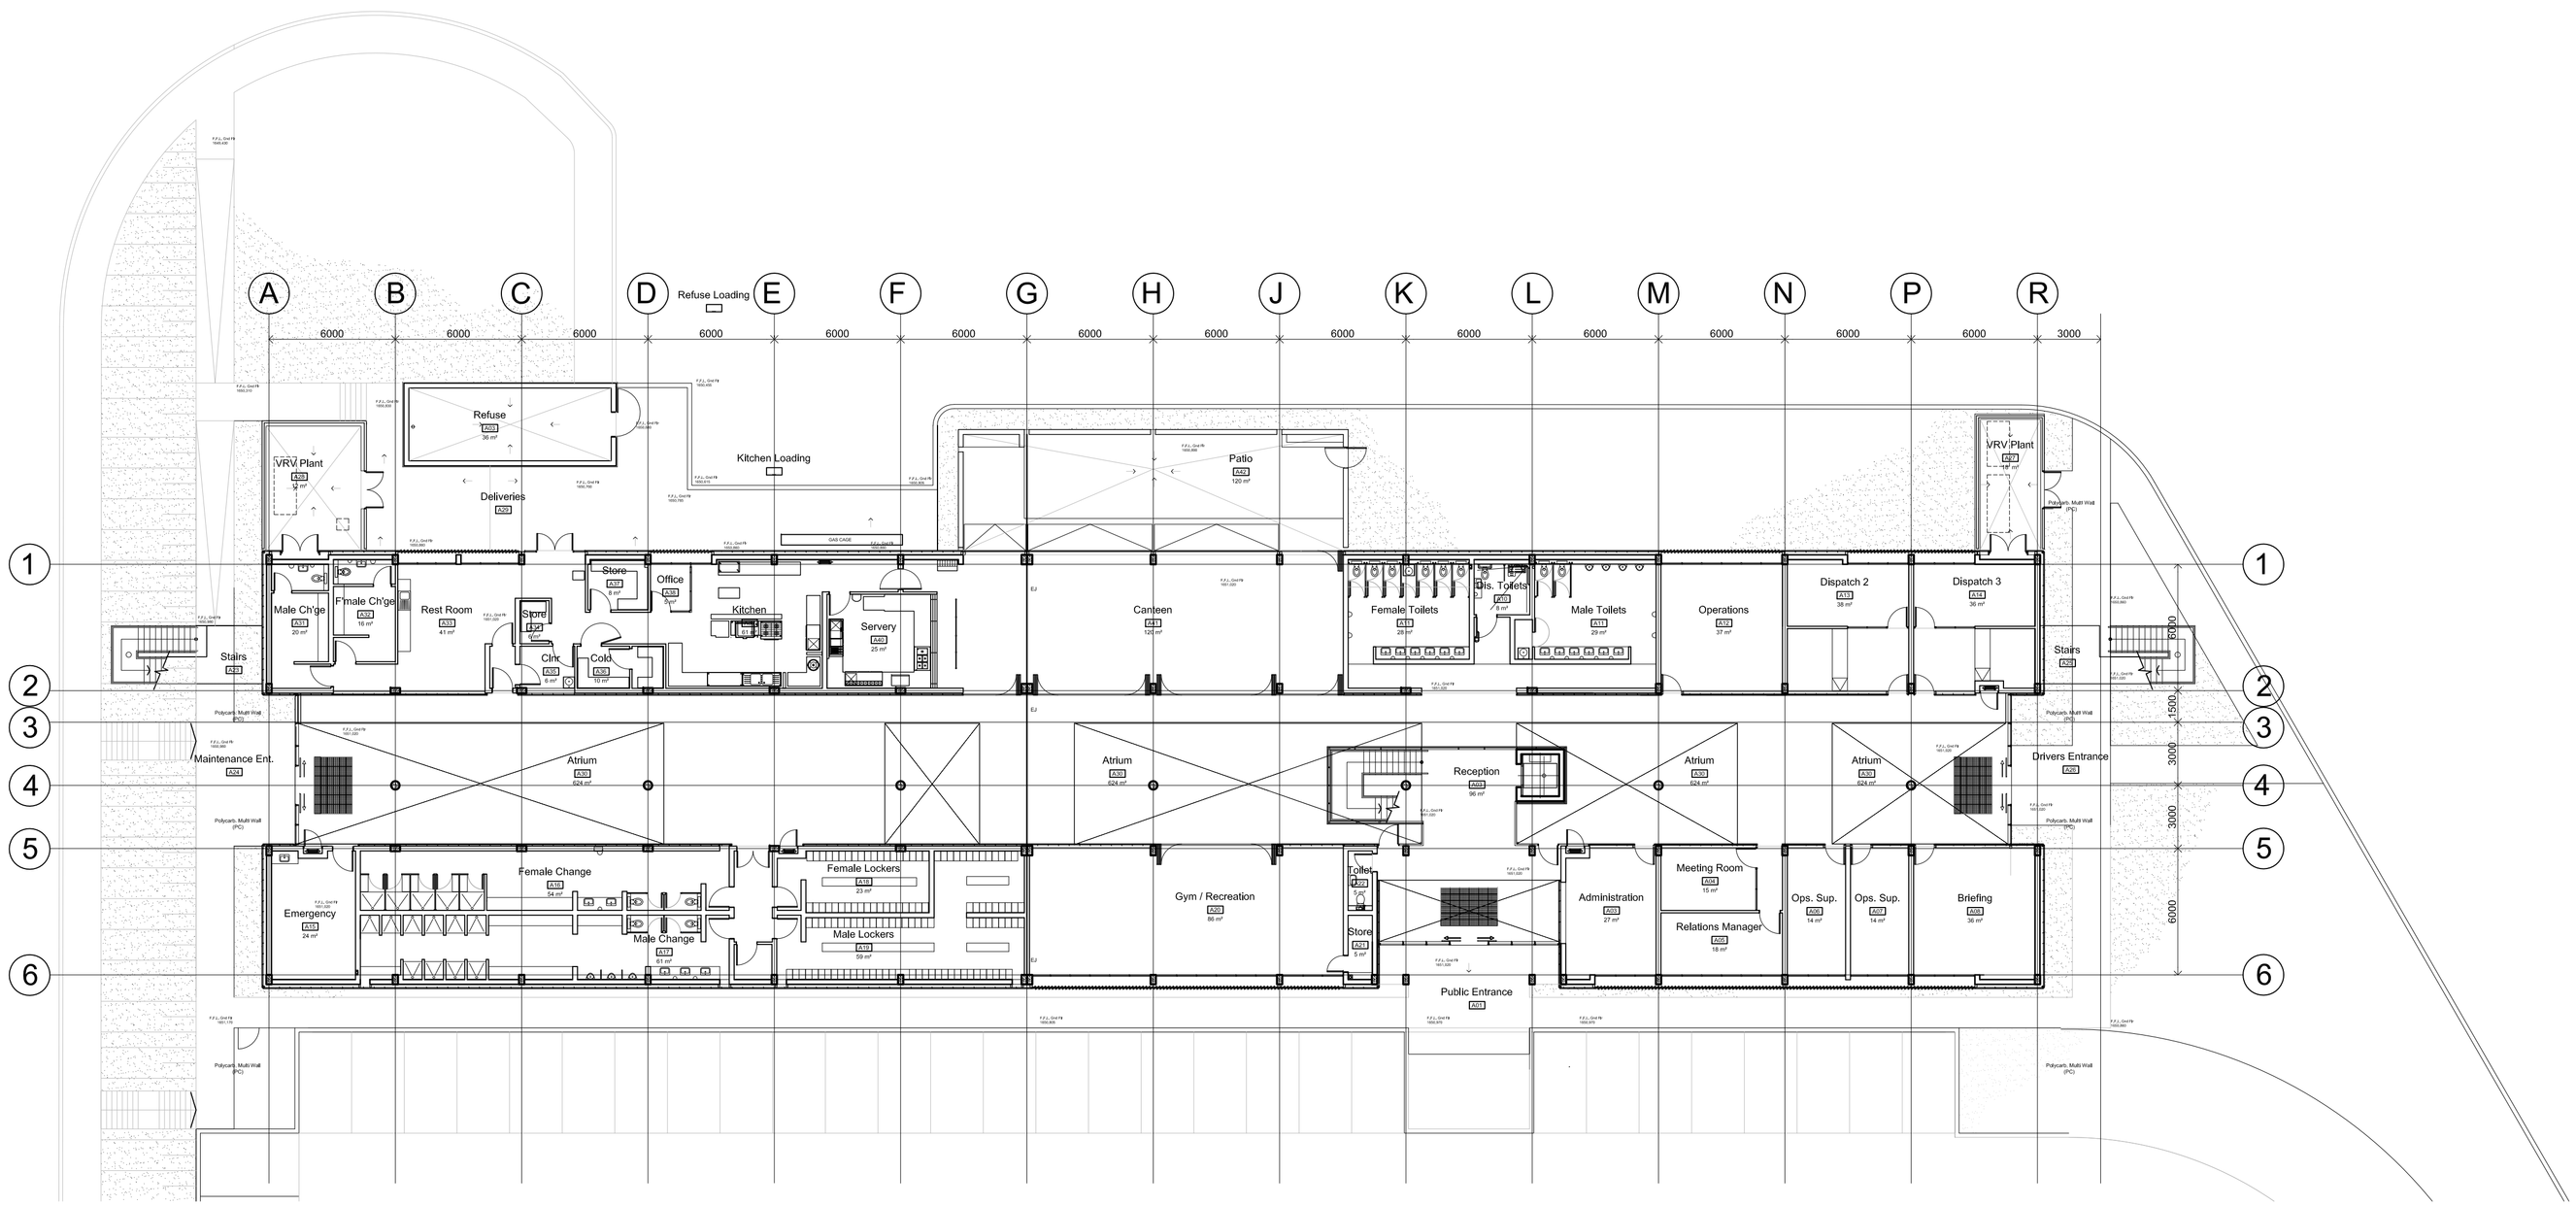

Ground Floor Plan

Scale 1:200 @ A1

North Point

ALL DIMENSIONS AND LEVELS ARE TO BE VERIFIED ON SITE BY THE CONTRACTOR BEFORE COMMENCING ANY WORK.

This document and all the information thereon remains the property of ARUP and may not be copied, reproduced or transmitted in part or in full without the written consent of ARUP. This document should not be relied on nor used in circumstances other than those for which it was originally prepared and for which ARUP was commissioned, as defined on this document. Refer to the contract for full terms and conditions.

ARUP shall not be liable for the consequences of using this document other than for the purpose for which it was commissioned. Any user and any other person using or relying on the document for such other purpose, will by such use or reliance be taken to confirm his agreement to indemnify ARUP for all loss or damage resulting there from.

Key Plan

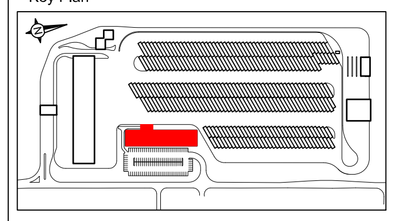

Issue	Date	By	Chkd	Appd

Architects

ARUP
Interchange Design

10 High Street, Melrose Arch, Johannesburg, Gauteng, South Africa
Postnet Suite 93, Private Bag X1, Melrose Arch, 2076
Tel: +27 (0)87 741 2200
Fax: +27 (0)87 741 2201
www.arup.com

Client

JDA

Job Title

REA VAYA Bus Depot
Dobsonville Main Depot
ERF 19/233-IQ & 20/233-IQ

Drawing Title

Administration Building
Ground Floor Plan
First Floor Plan

Scale at A1 1:200

Plot ID

Drawing Status

AS BUILT

Job No	Drawing No	Issue
181759.02	A-A-211	0

© Ove Arup Partnership Ltd